

580 E. 12 MILE ROAD, SUITE A
 WARREN HEIGHTS, MI 48071
 PH: (586) 767-0080
 FAX: (248) 398-3822
 E-mail: imad@potresdesign.com

DESIGNED BY:
 Imad Potres

REVISIONS:

1-	AS-BUILT	03/29/22
2-		
3-		
4-		
5-		
6-		
7-		

MICHIGAN WORKS
 27850 VAN DYKE AVE
 WARREN, MI 48093

SEAL / SIGNATURE


DATE:


DRAWING TITLE:
EXISTING FLOOR PLAN
 PROJECT NO.: 022-03
 FILE NAME: MAJESTIC

DRAWN BY: IMAD
 CHECKED BY: IMAD
 DATE: 03/30/2022

SHEET NO:

A01

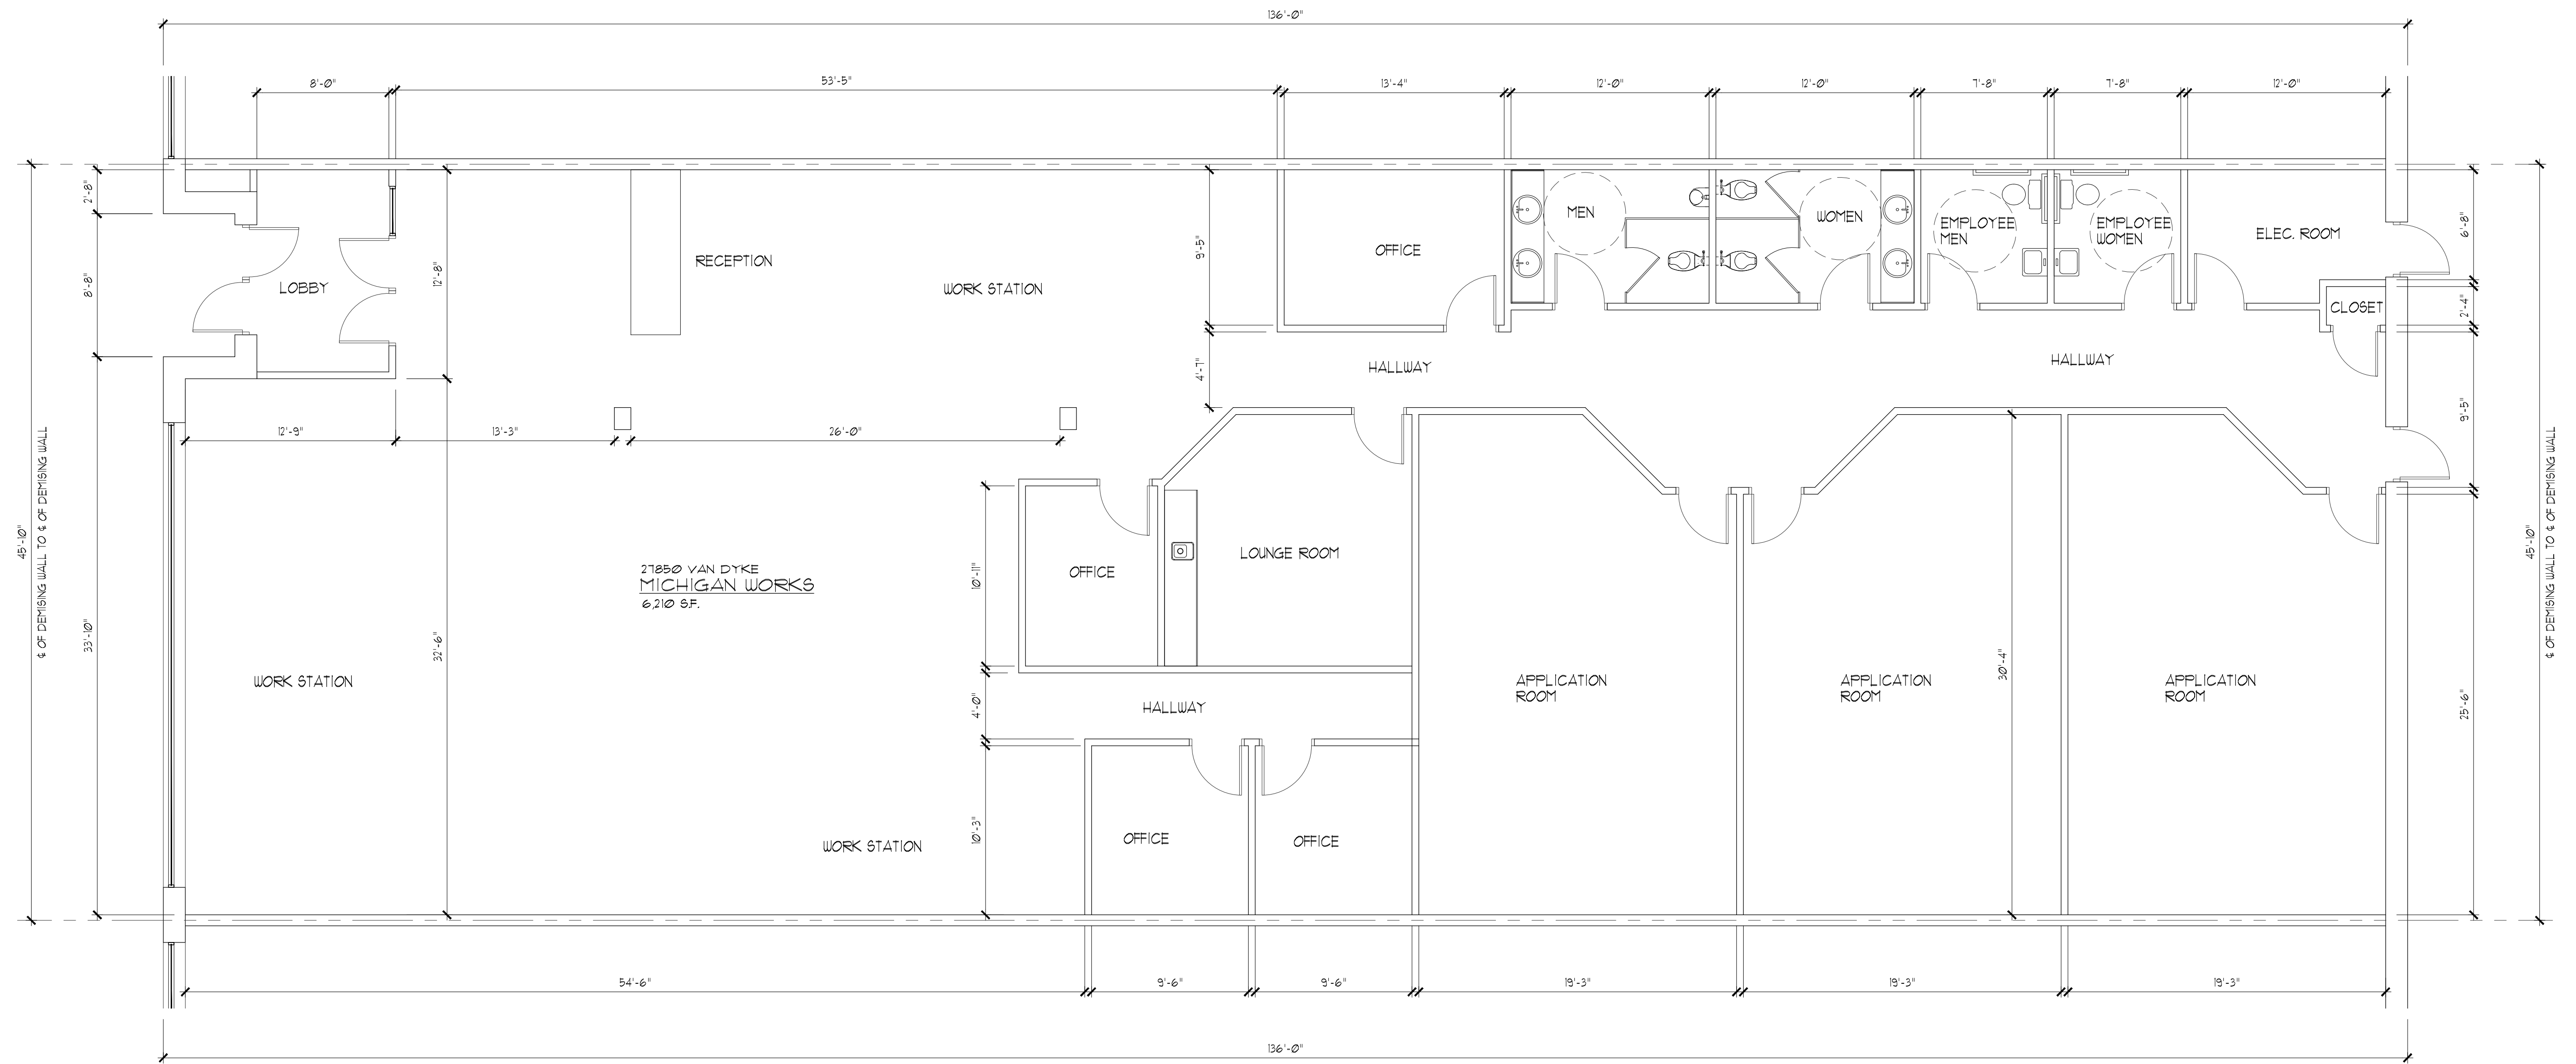

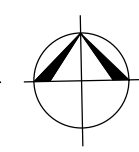EXISTING FLOOR PLAN 
 SCALE: 3/16"=1'-0"